


**TERRA LINDA HIGH SCHOOL  
SAN RAFAEL, CA  
PRE-CCTV SEWER**

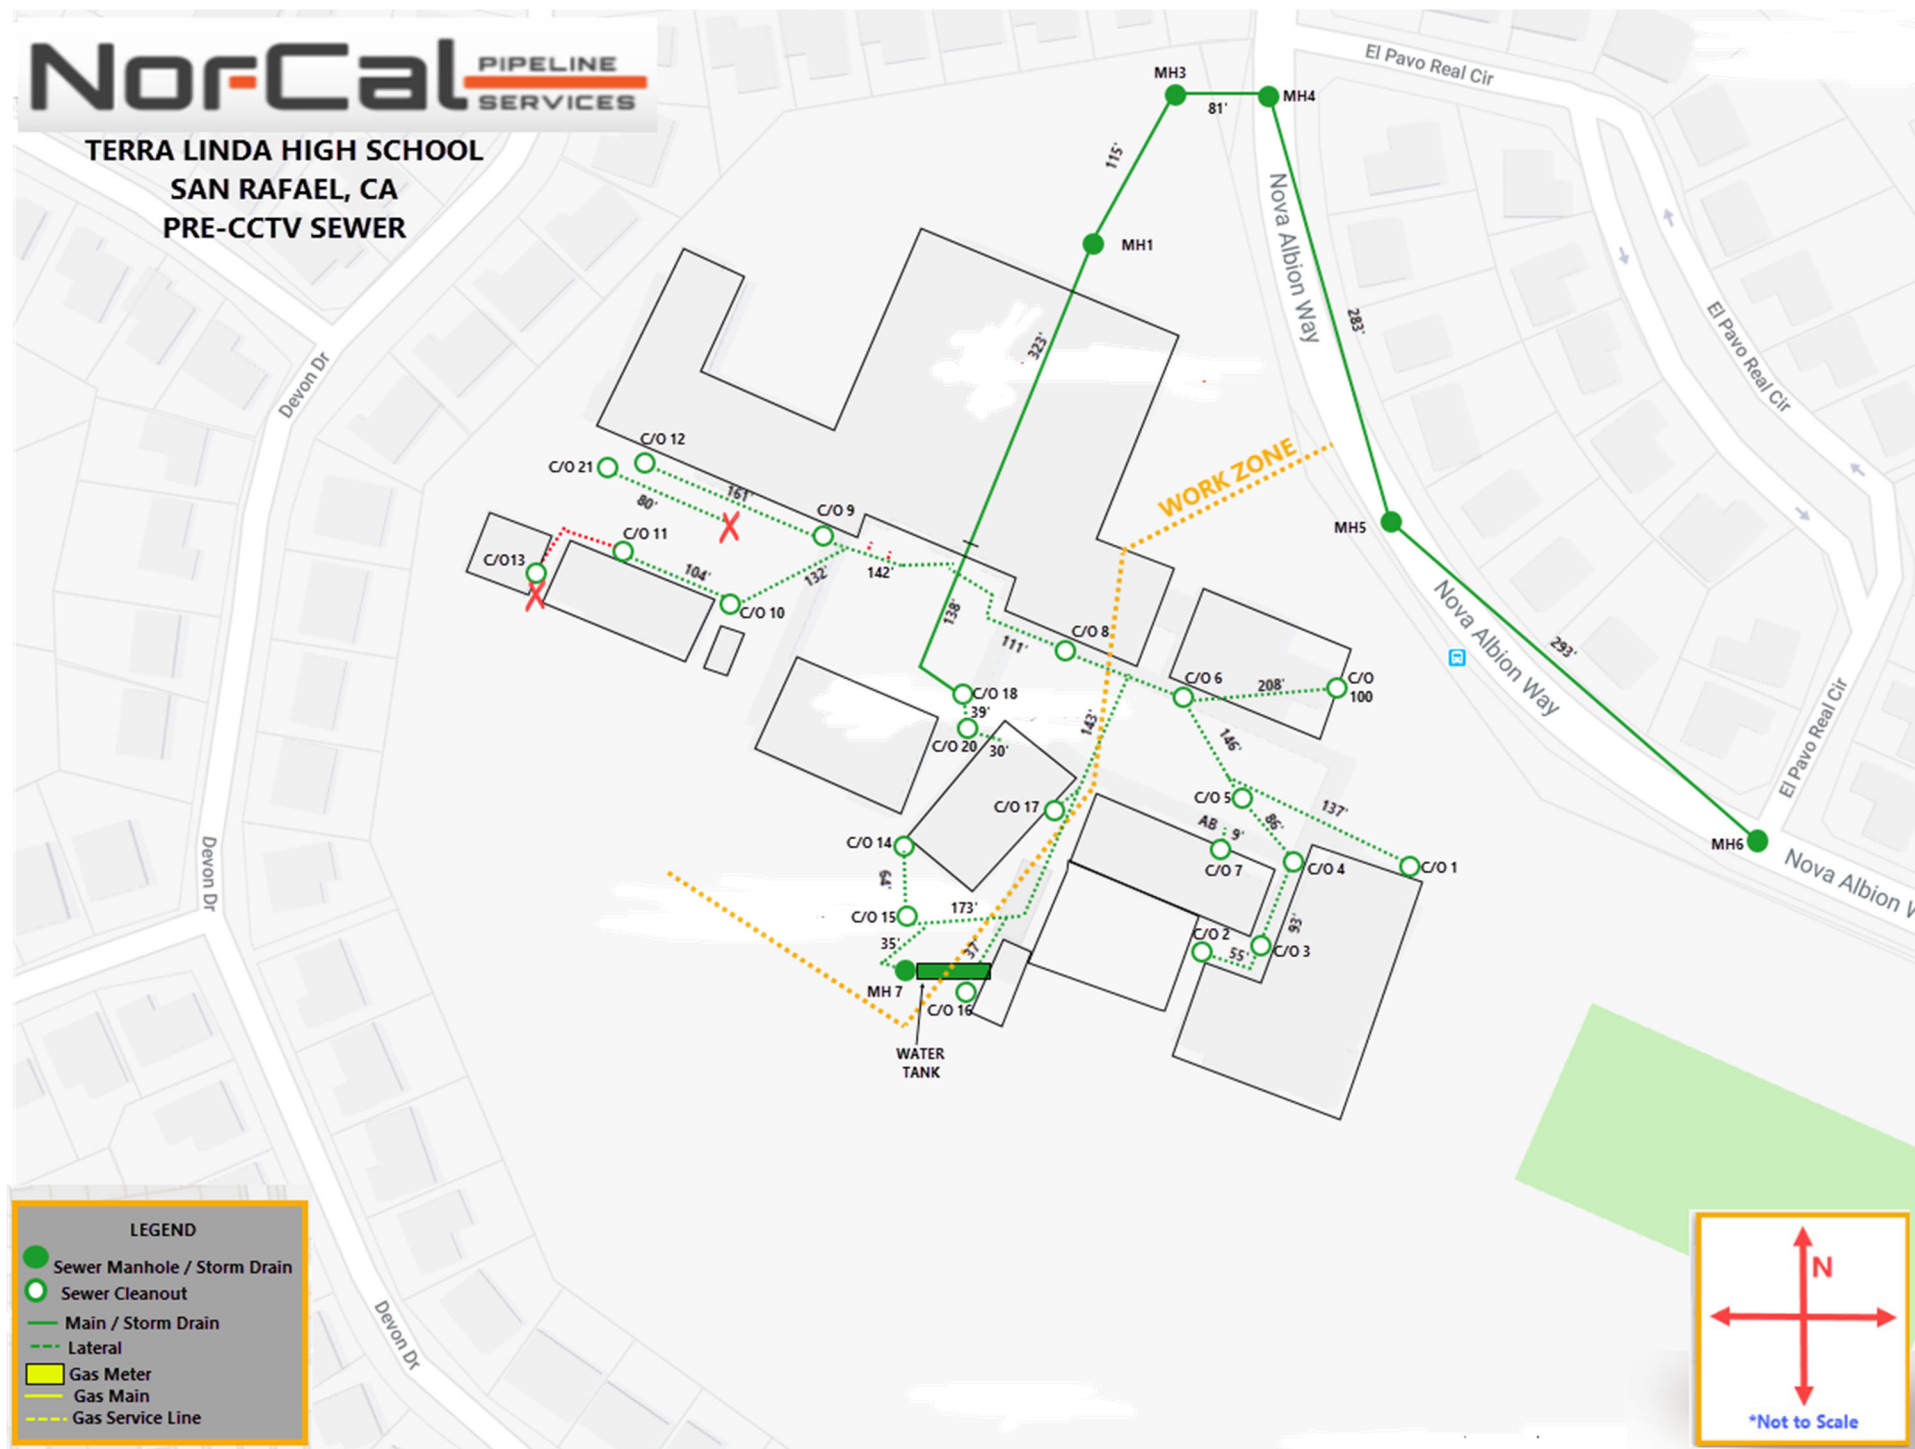

## TERRA LINDA HIGH SCHOOL SAN RAFAEL, CA PRE-CCTV STORM

