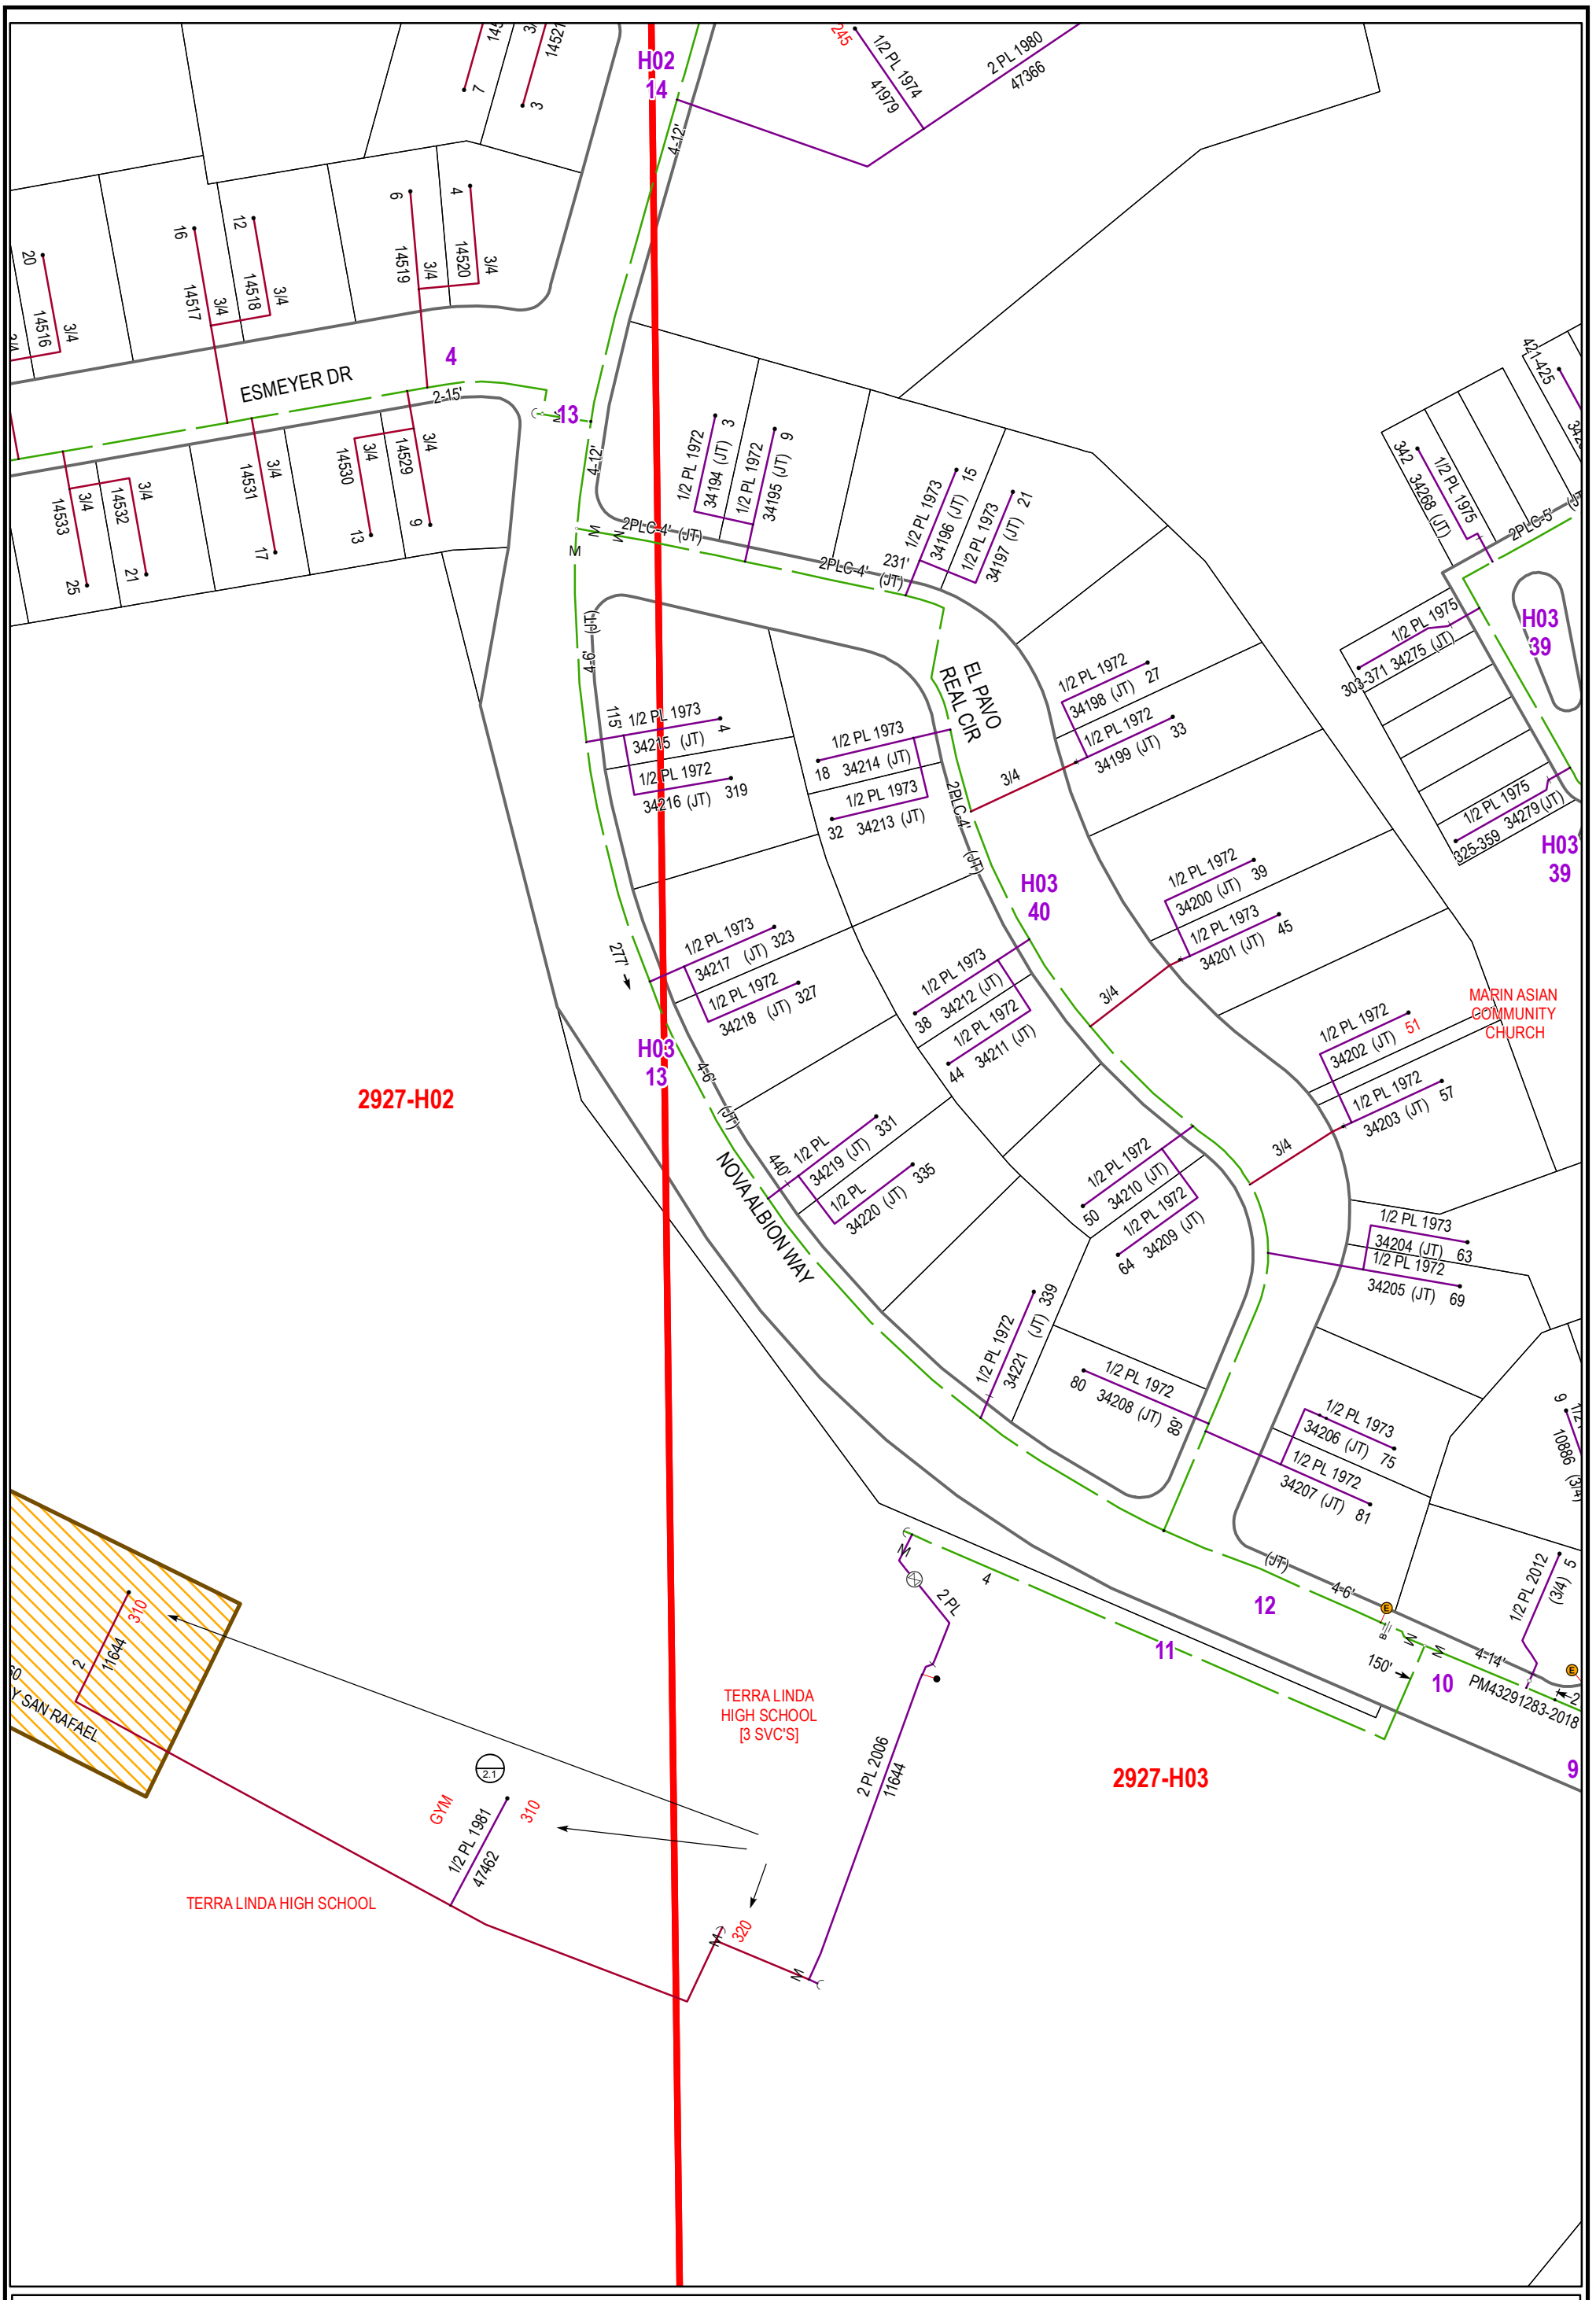

"WARNING: Confidential, Proprietary Information

This document contains confidential, proprietary information that is the sole property of Pacific Gas and Electric Company (PG&E) and is intended for use only by authorized PG&E employees and agents.

Copyright Pacific Gas and Electric Company 2020"

PACIFIC GAS & ELECTRIC COMPANY

TLHS

SCALE : 1 inch = 100 feet

60 0 60 120 180 Feet

Reference PG&E's GIS for the most current information

Printed on: 3/31/2020

No engineering decisions related to proposed acceptable facility clearances from PG&E facilities, construction methods over or under PG&E facilities, wheel loading, or cuts/fills over PG&E facilities should be determined from these maps. All improvement plans must be reviewed by PG&E engineering